



AS-BUILT PLANS 12/12/12




DETAIL "A"(YELLOW)

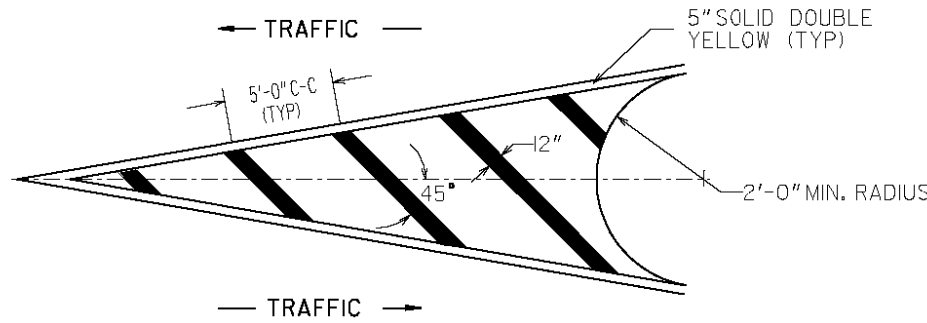


DETAIL "B"(YELLOW)

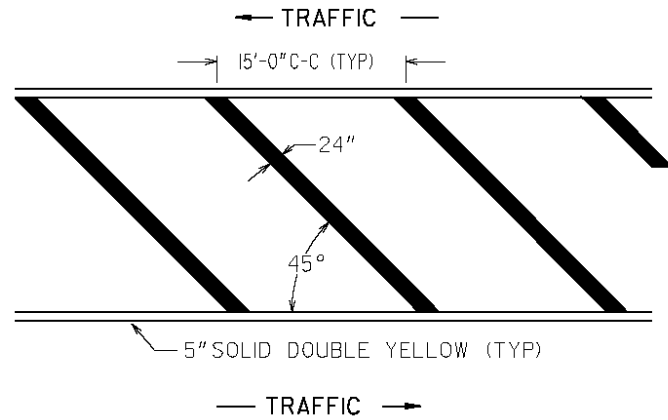


DETAIL "C"(YELLOW)

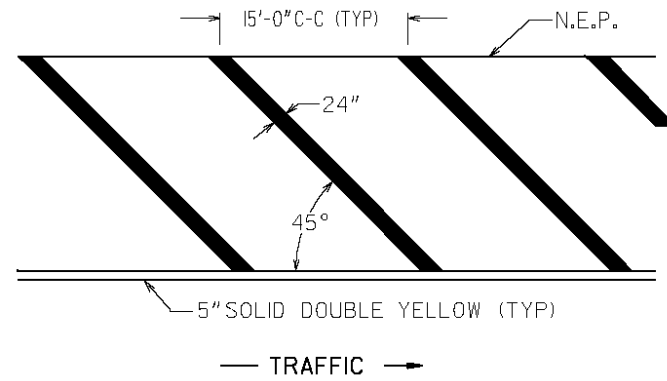


DETAIL "D"(YELLOW)

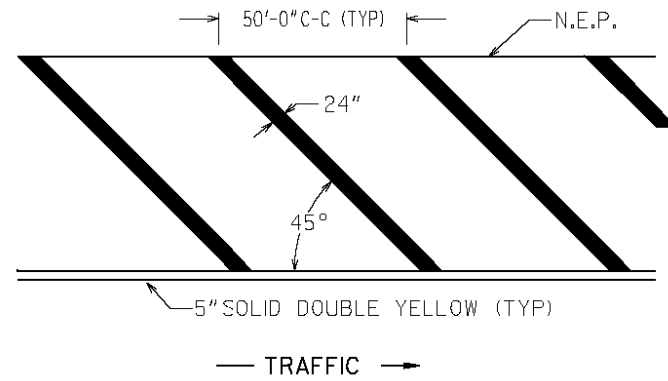


DETAIL "A"(WHITE)

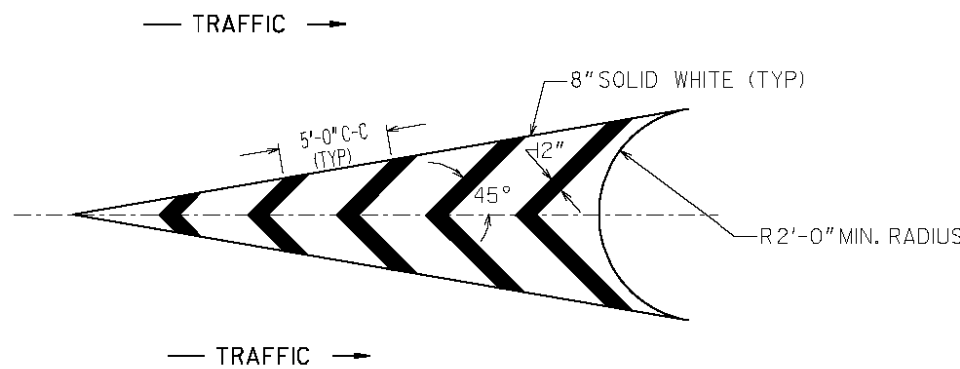


DETAIL "B"(WHITE)

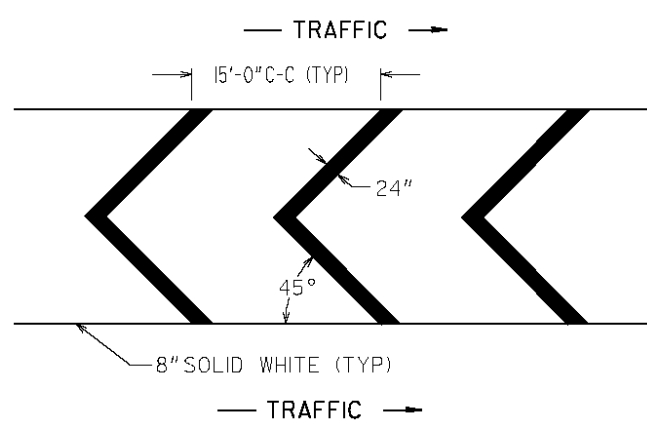

DETAIL "C"(WHITE)

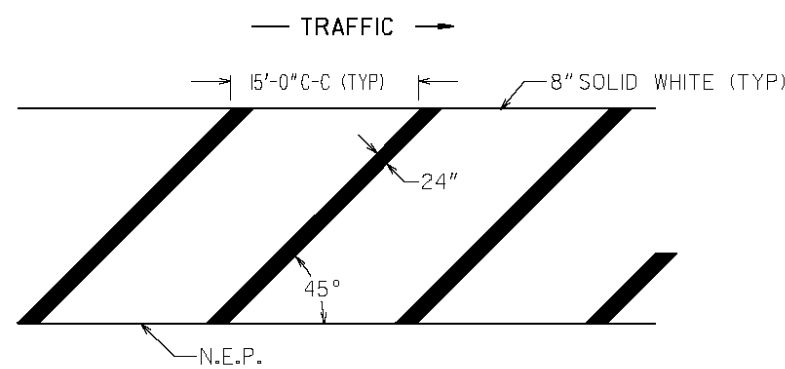

DETAIL "D"(WHITE)

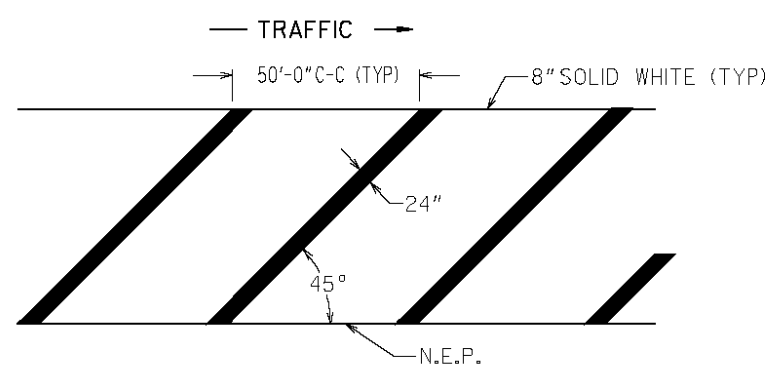

GENERAL NOTES:

1. FOR YELLOW STRIPING, THE SQUARE YARDS SHOWN ON PLAN, SUMMARY AND DETAILED ESTIMATE SHEETS INCLUDE THE AREA WITHIN THE BORDERS AND THE 5" SOLID DOUBLE YELLOW BORDER.
2. FOR WHITE STRIPING, THE SQUARE YARDS SHOWN ON PLAN, SUMMARY AND DETAILED ESTIMATE SHEETS INCLUDES THE AREA WITHIN THE BORDERS AS WELL AS THE 8" SOLID WHITE BORDER.

GEORGIA
DEPARTMENT
OF
TRANSPORTATION

- NO SCALE -

DATE	REVISIONS	STATE OF GEORGIA DEPARTMENT OF TRANSPORTATION OFFICE: TRAFFIC OPERATIONS SIGNING AND MARKING PLANS DETAIL OF PAVEMENT MARKING HATCHING JANUARY 2000	NUMBER I-14 T -14
6/25/04	Modified general note 1		
1/18/05	CHANGED BORDER		
11/21/08	Modified general note 1		

THE
LPA
GROUP
TRANSPORTATION CONSULTANTS
3595 ENGINEERING DRIVE
NORCROSS, GEORGIA 30092
(770) 283-9118

REVISION DATES

STATE OF GEORGIA
DEPARTMENT OF TRANSPORTATION
OFFICE: INNOVATIVE PROGRAM DELIVERY
CONSTRUCTION DETAILS

DRAWING No.
40-033